

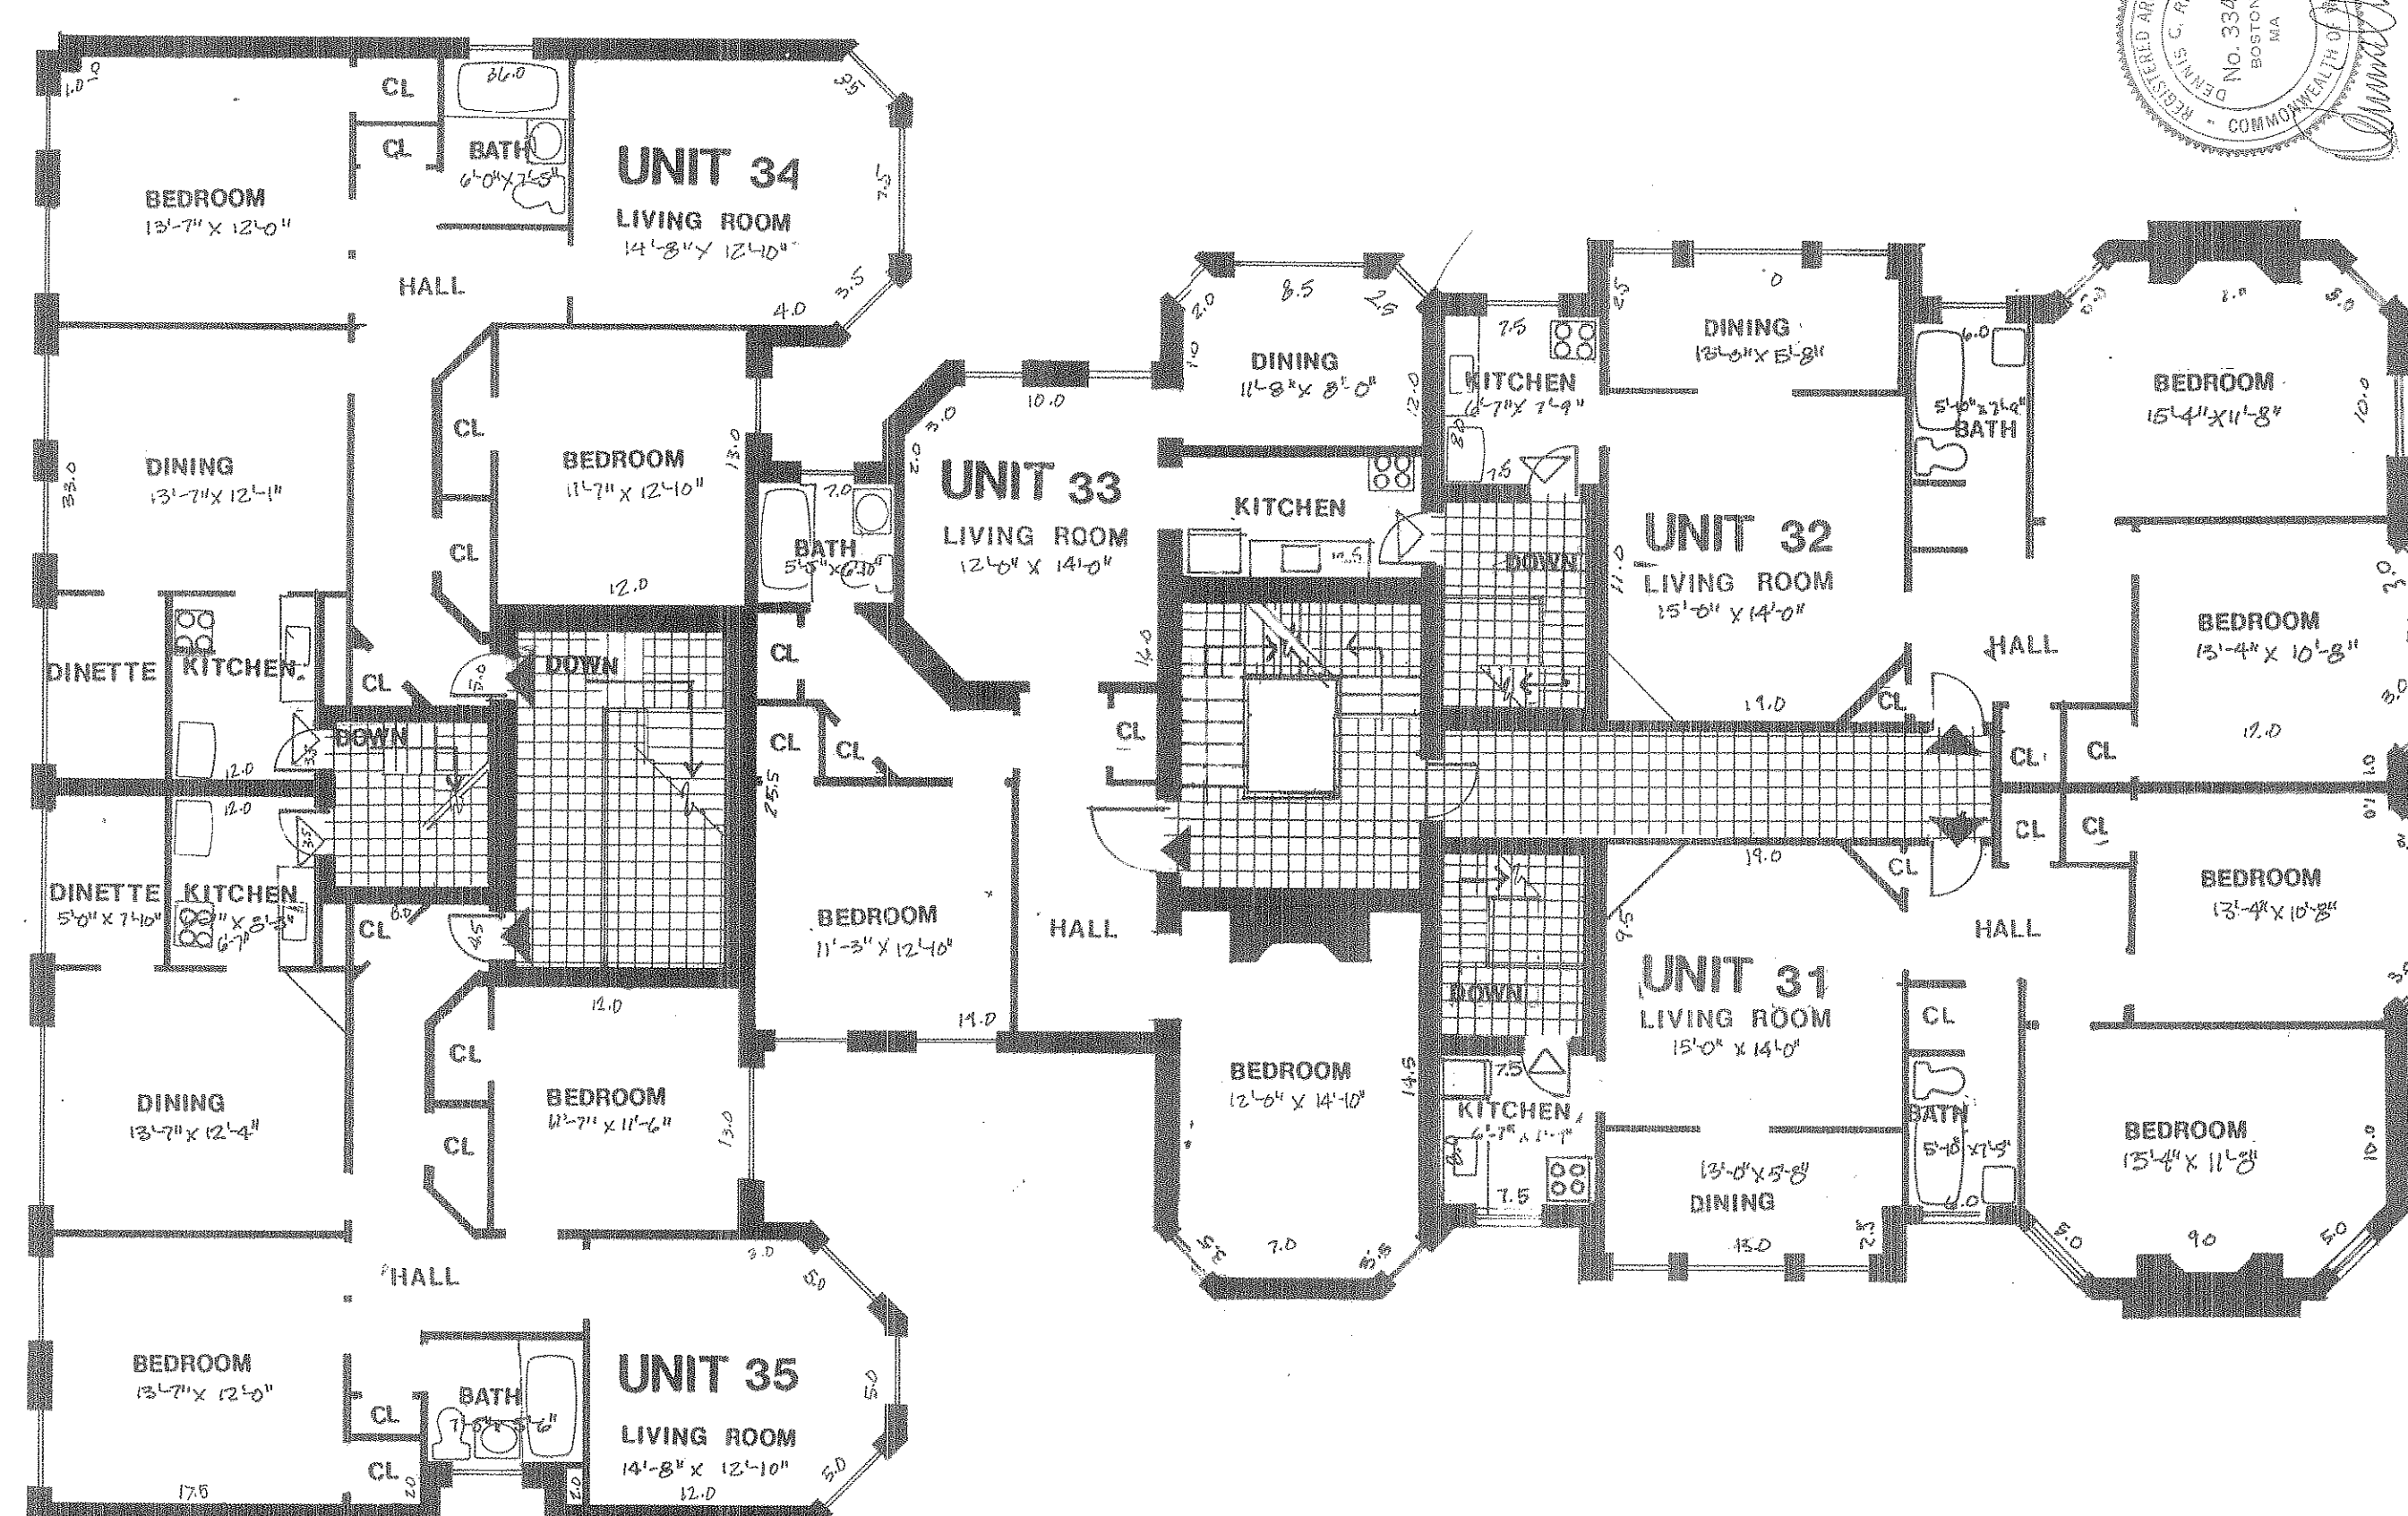



SECOND FLOOR

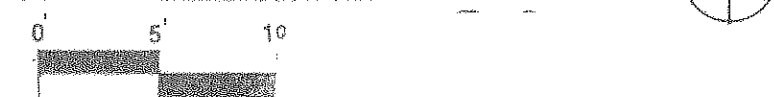



THIRD FLOOR

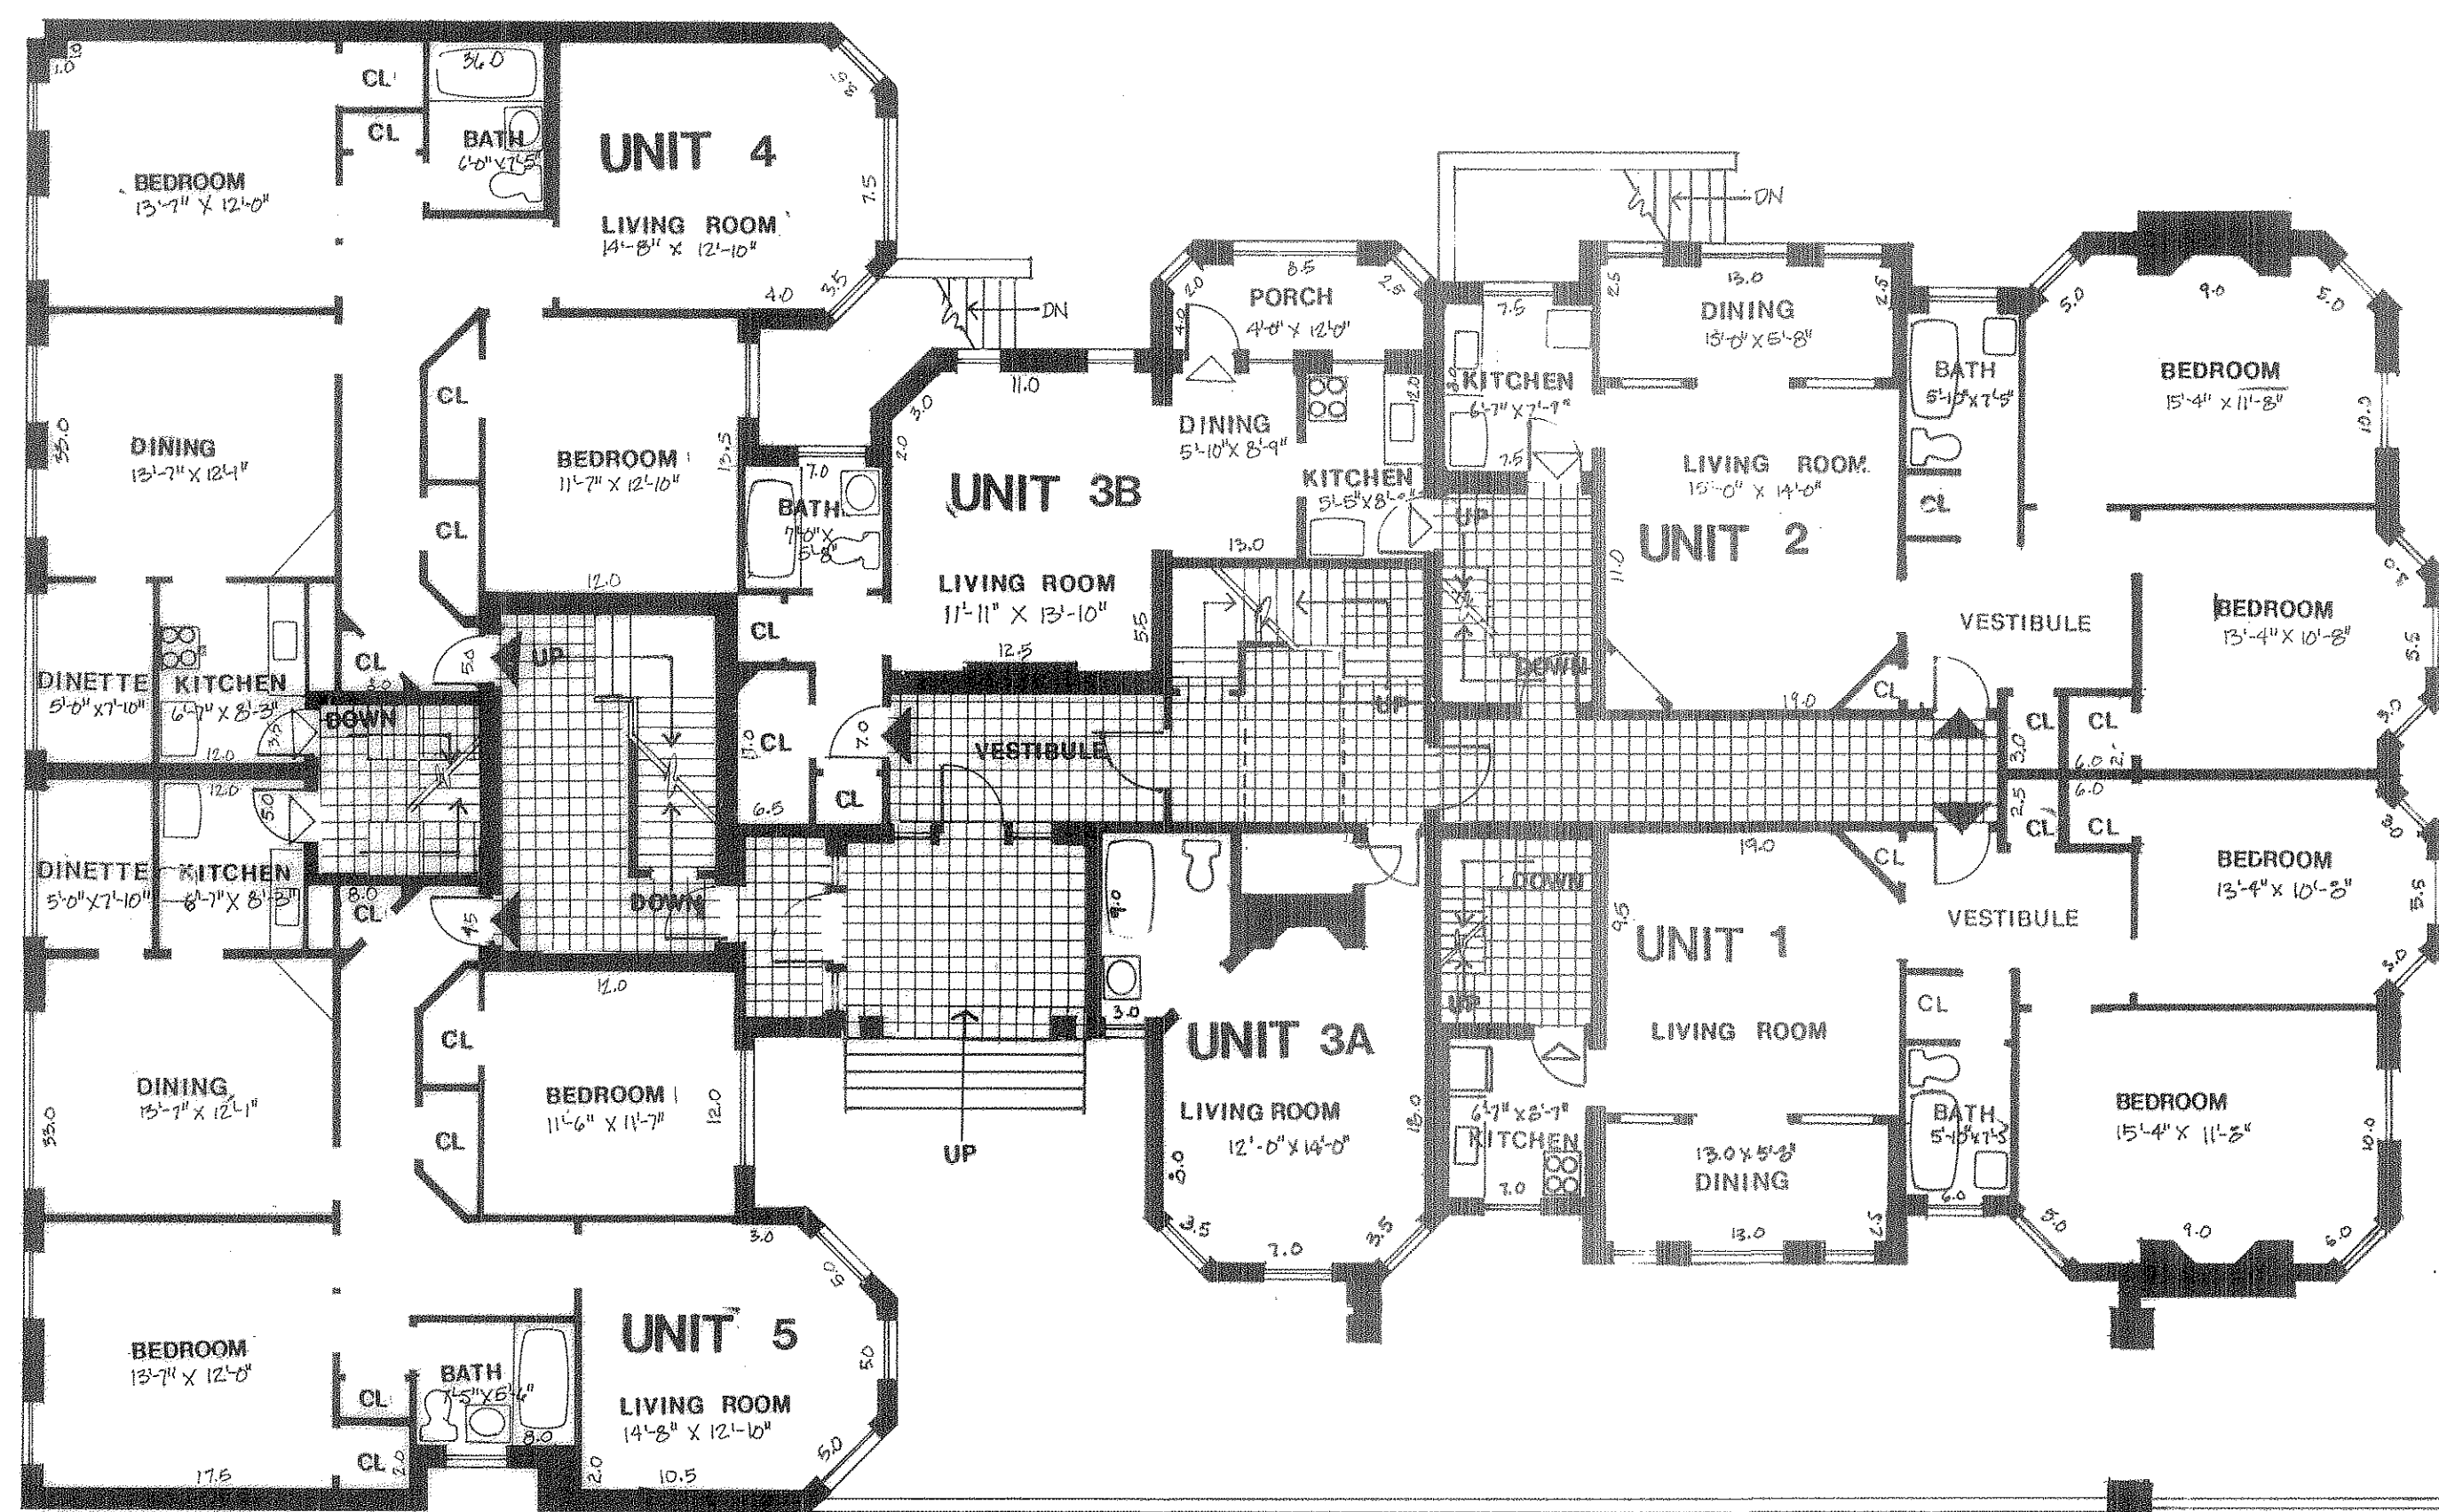

FIRST FLOOR

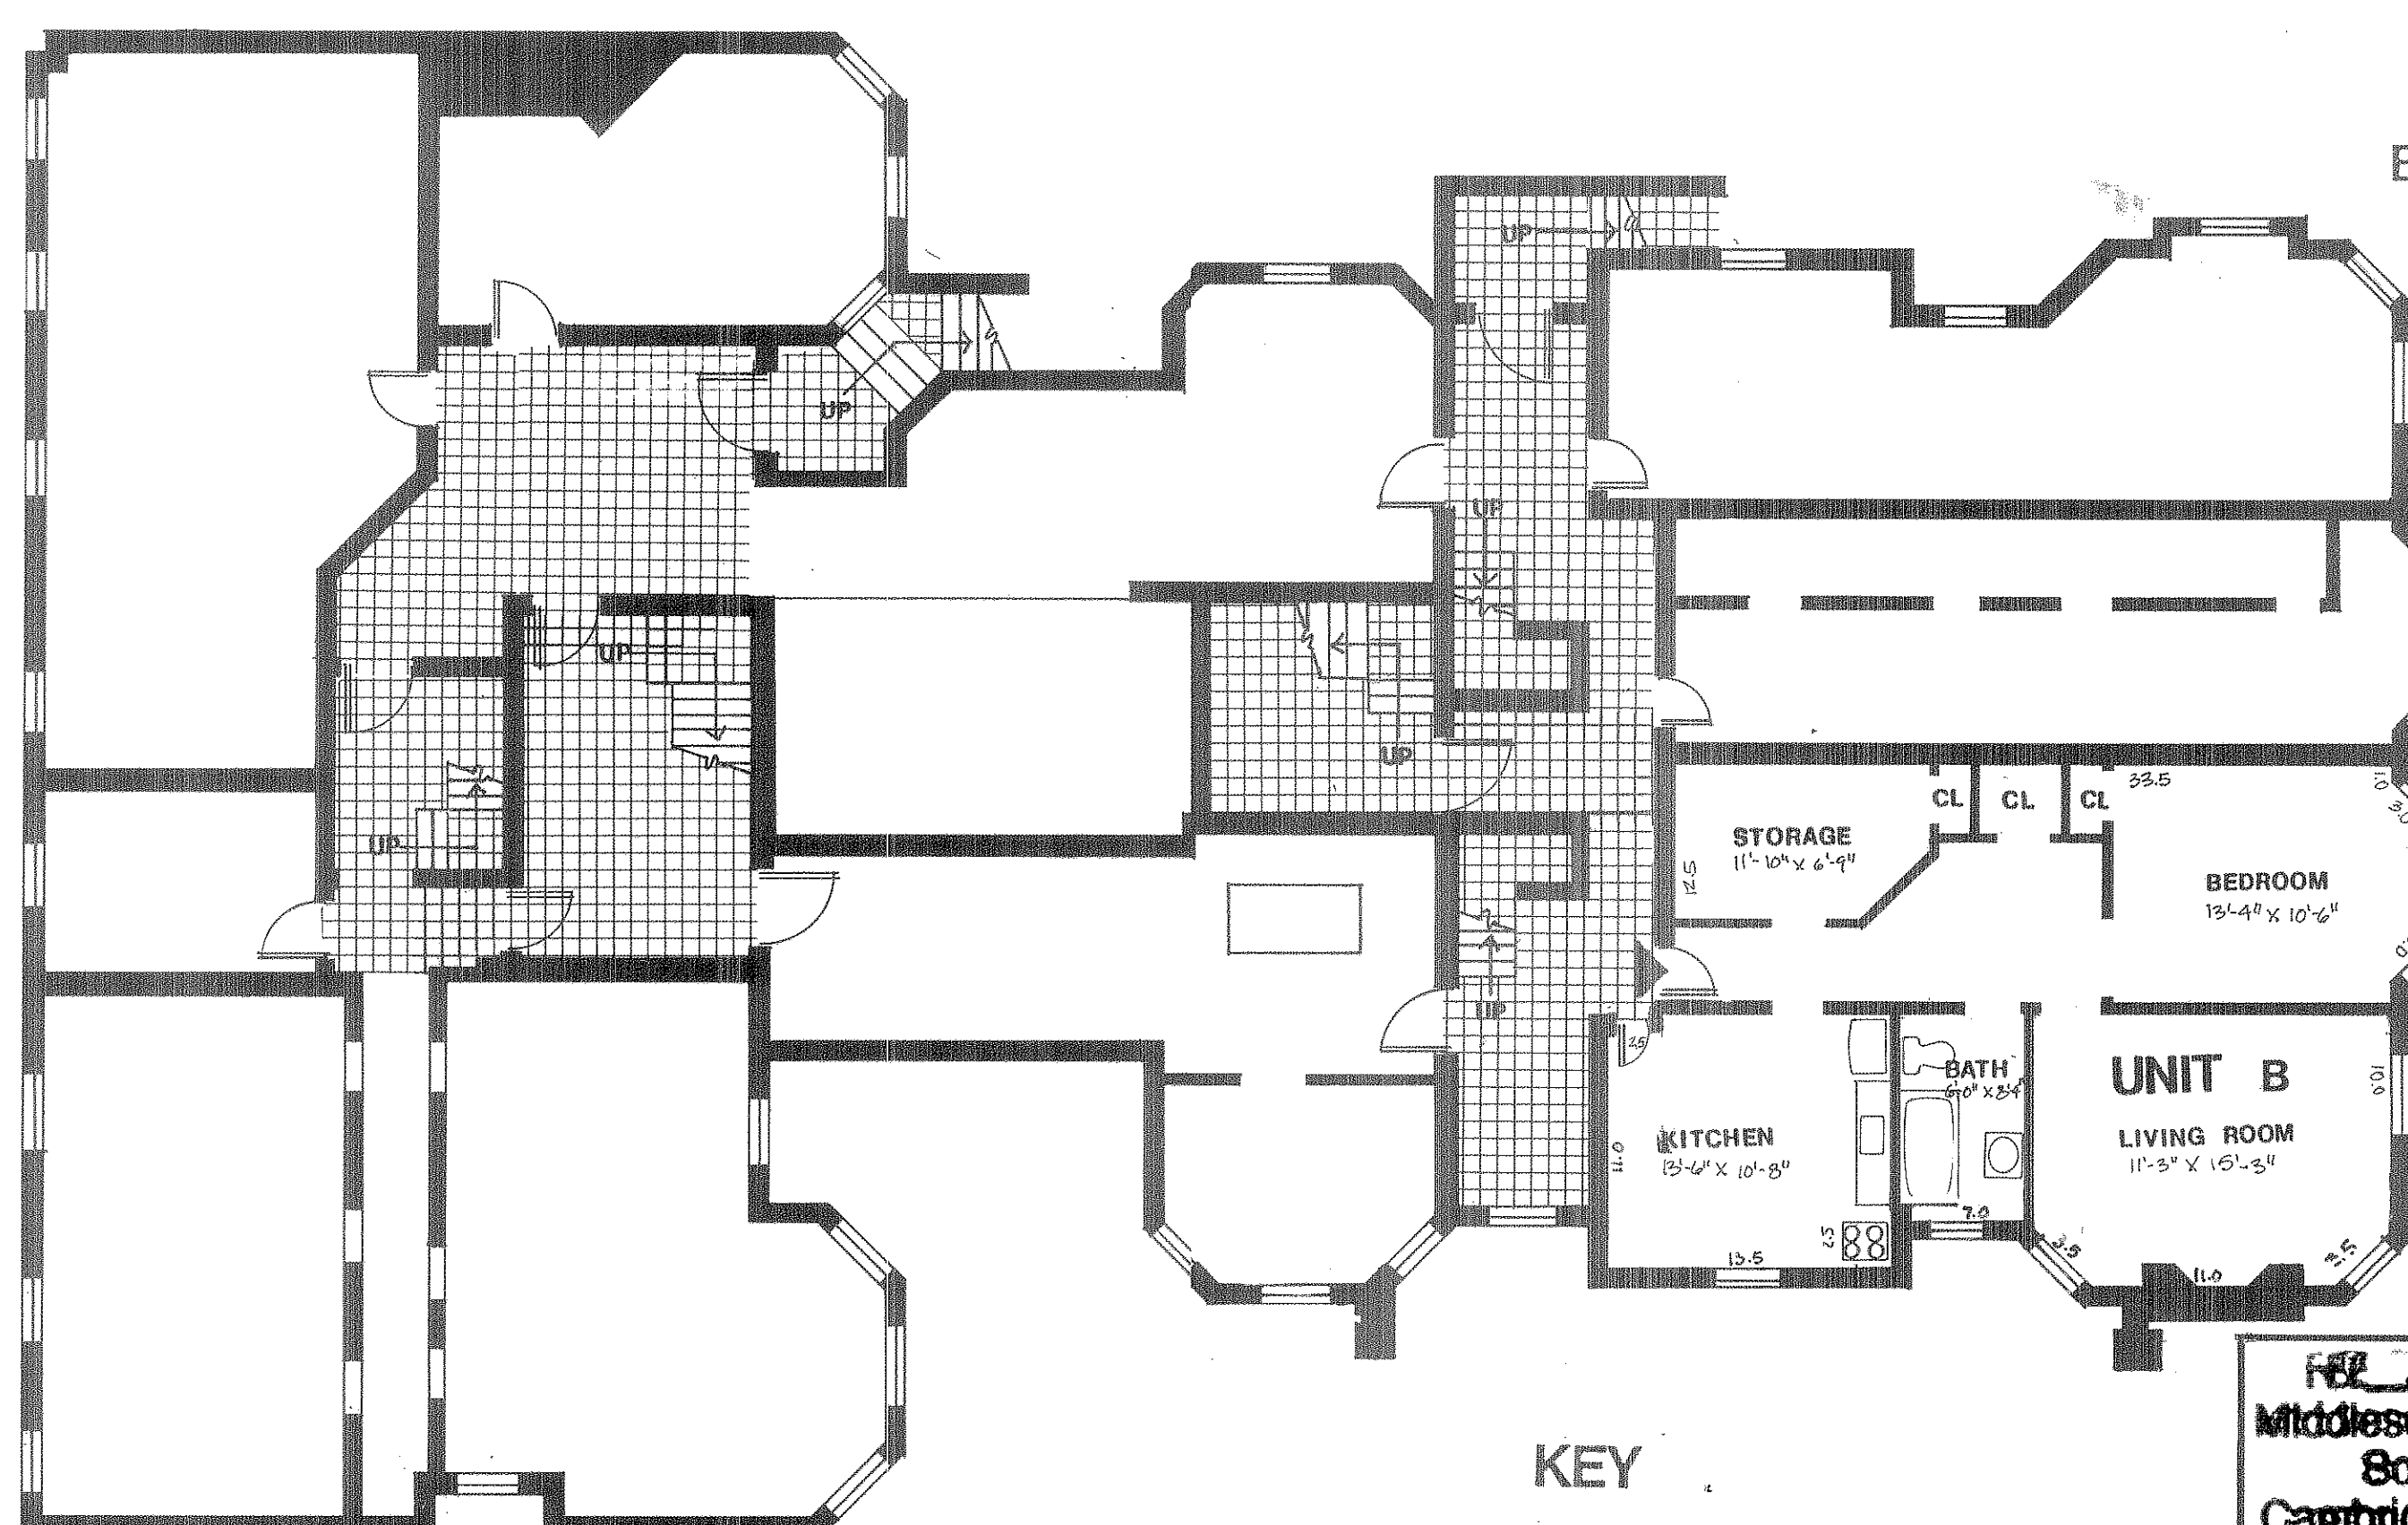


BASEMENT

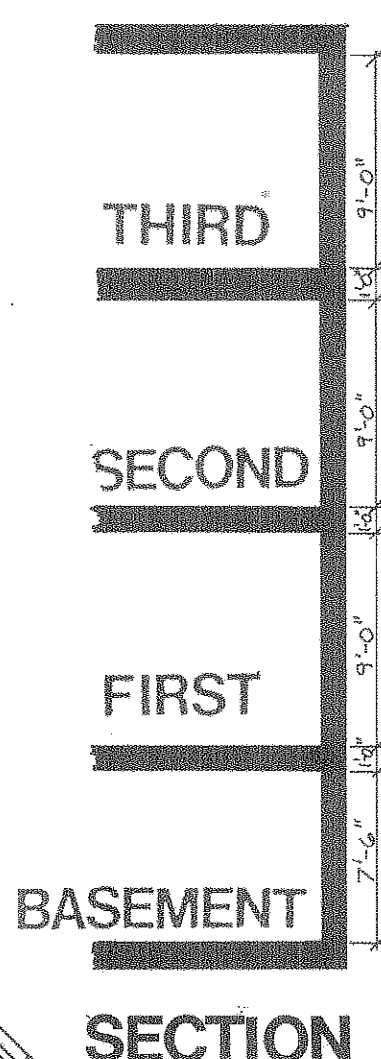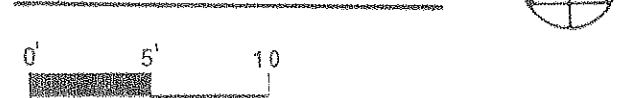

KEY

CL = CLOSET

MAIN UNIT ENTRANCE MAIN UNIT EXIT

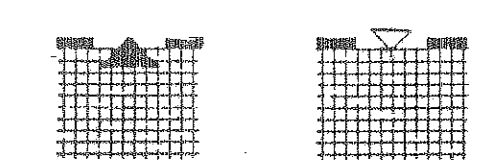

REC 25- BY J.R.
Middlesex Registry of Deeds
Southern District
Cambridge, Massachusetts
Plan No. 1369 of 1986
Rec'd OCT 3 1986
at 4:00 p.m. Doc No. 1035
Rec'd, Bk 17462 Pg 495
Attest *John J. [Signature]*
Register



TITLE
BASEMENT, FIRST, SECOND, & THIRD FLOOR PLANS

SCALE 1/8" = 1'-0"
DATE 5/4/83
DRAWN LEF
CHECKED
JOB NO.

19 AGASSIZ STREET CONDOMINIUM

DEVELOPMENTAL RESOURCES

119 MT. AUBURN STREET, CAMBRIDGE, MASSACHUSETTS 02138. TELEPHONE 491-3690

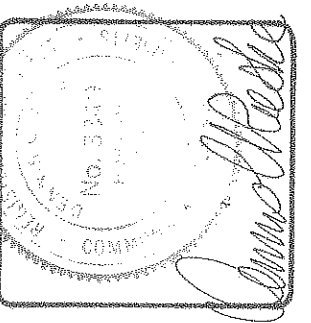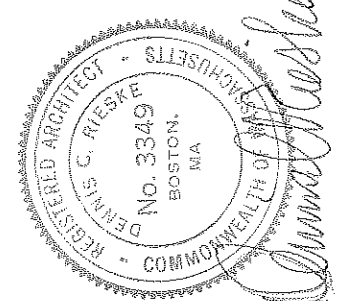

I certify that this plan has been prepared in conformity with the rules and regulations of the Registry of Deeds of the Commonwealth of Massachusetts.
I certify that this plan fully and accurately depicts the layout, location, unit number and dimensions of the units numbered 1, 2, 3A, 3B, 4, 5, 21 through 25, 31 through 35, inclusive, in the 19 Agassiz Street Condominium at 19 Agassiz Street, Cambridge, MA, as built.

This building has no name as of the date hereof.
AT 19 AGASSIZ STREET, CAMBRIDGE, MA